


- Single active EVC
- Dual active EVC

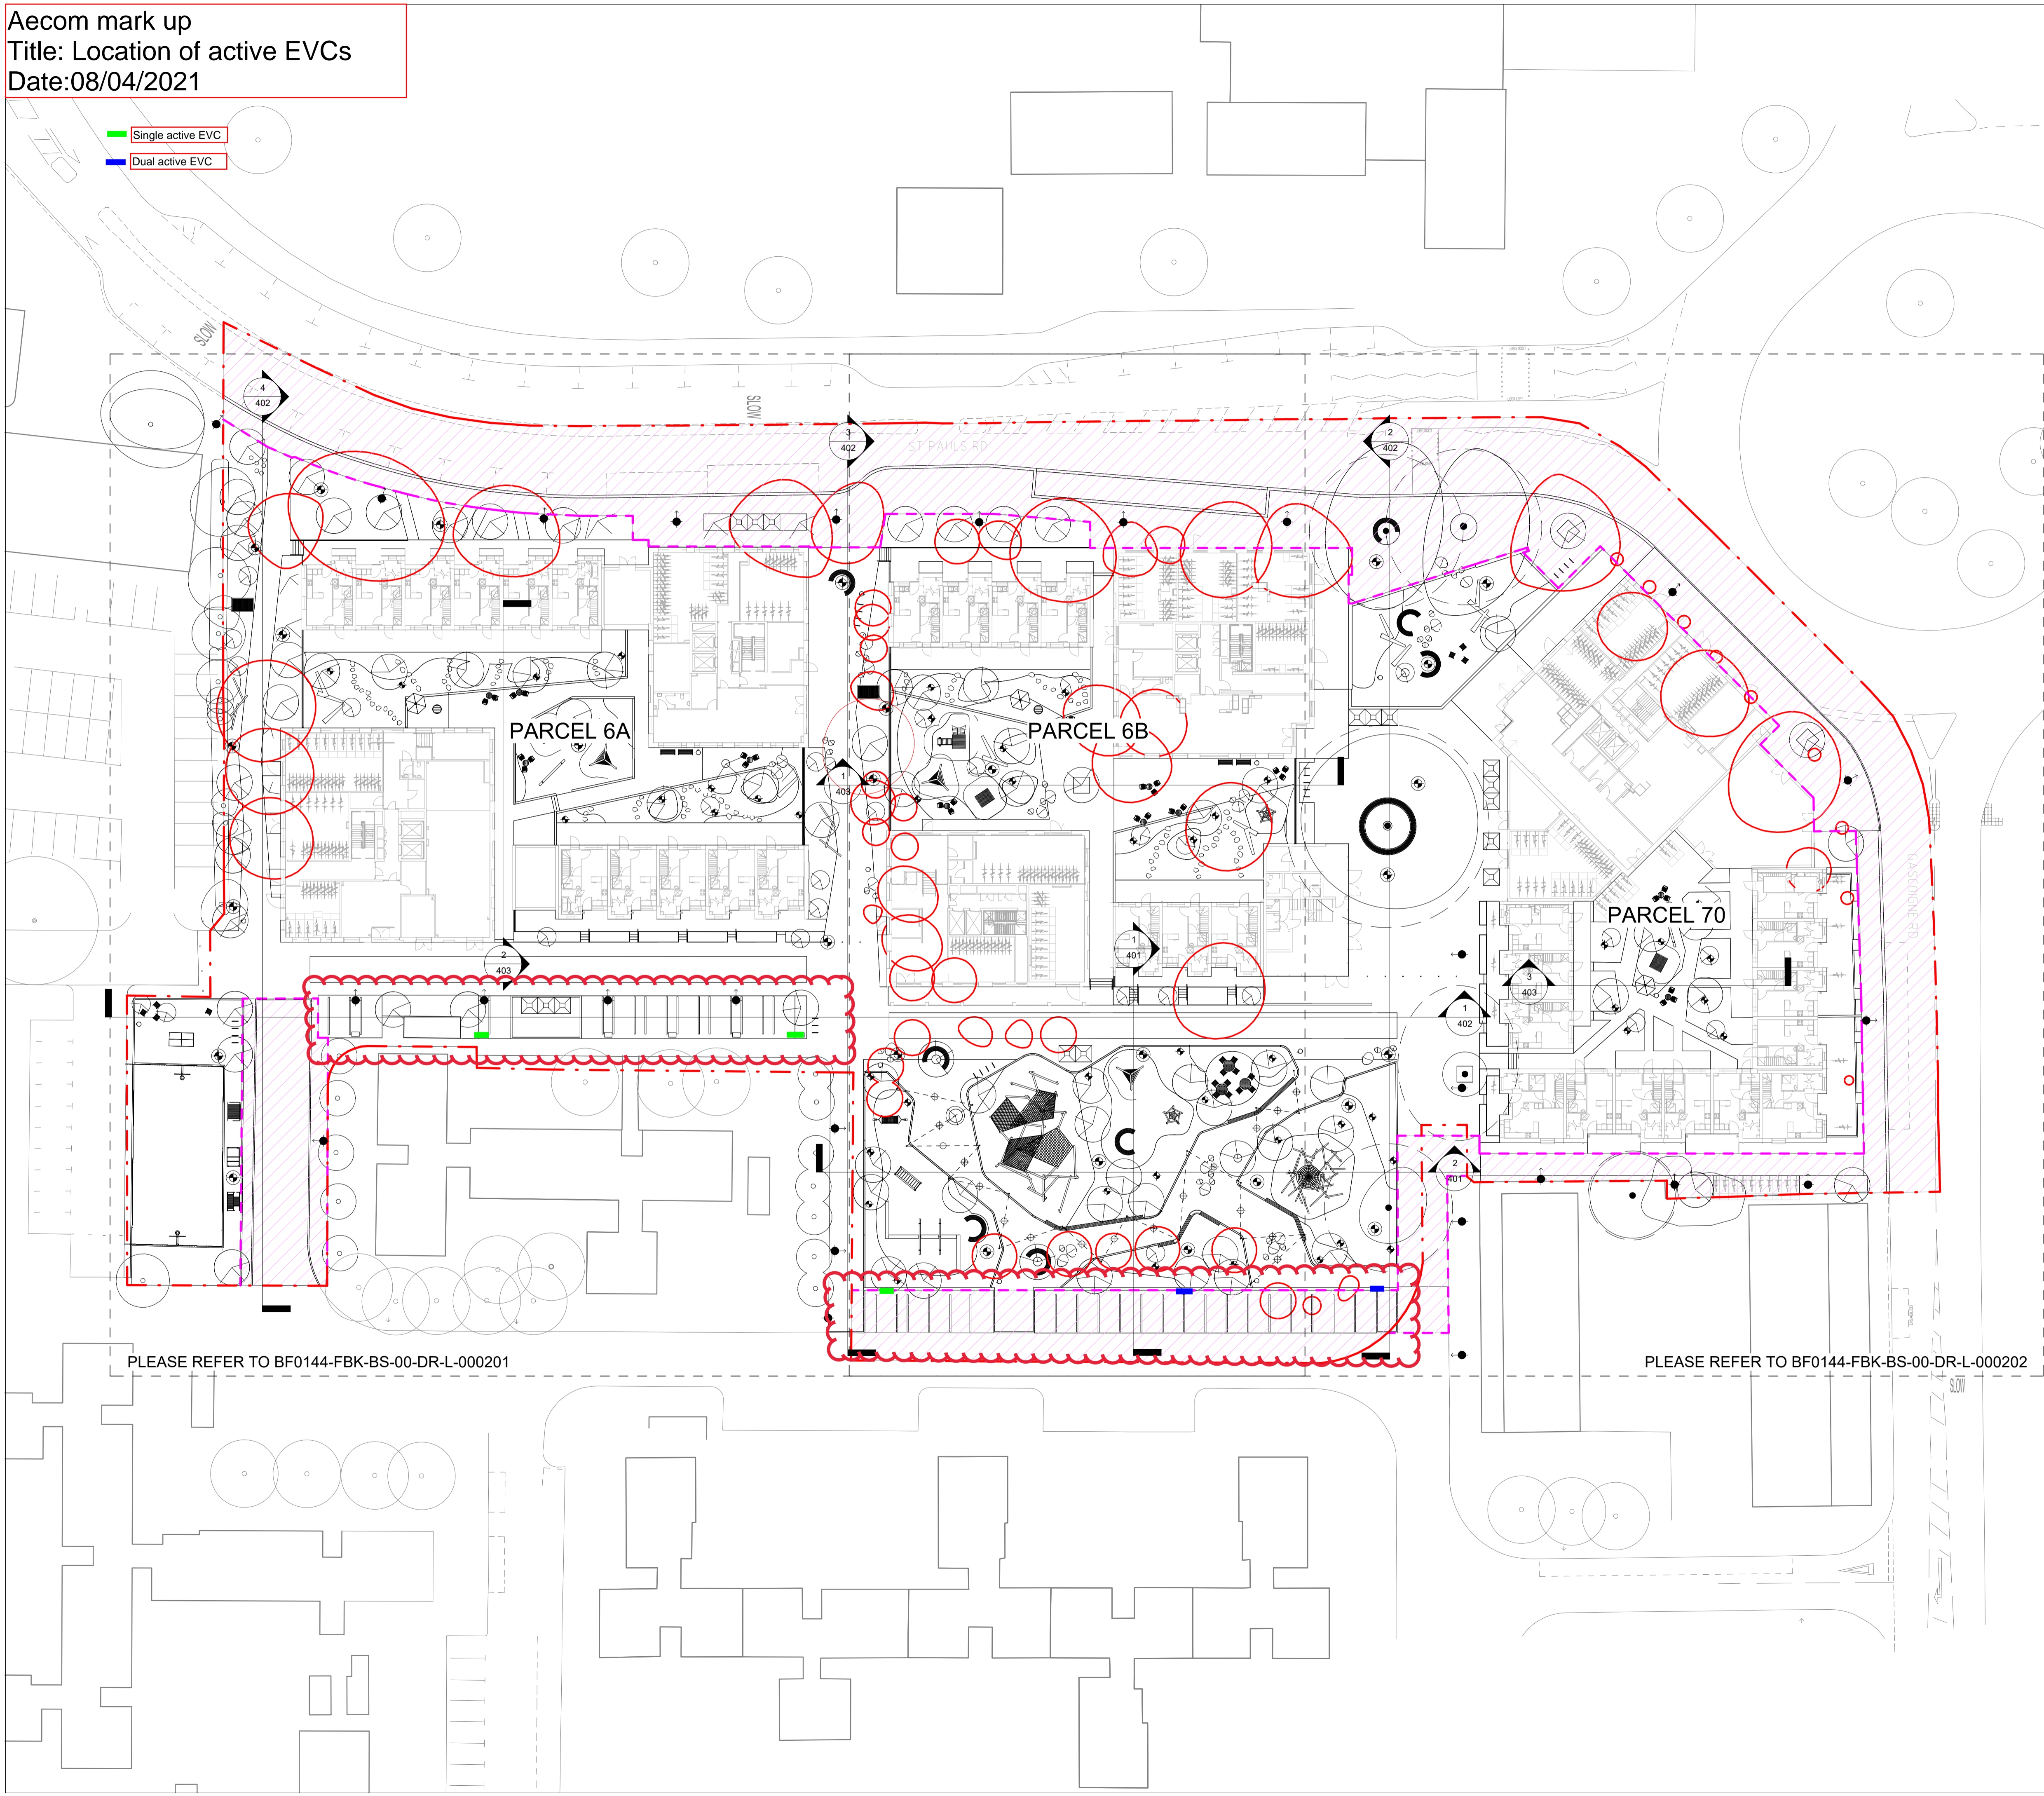

PLEASE REFER TO BF0144-FBK-BS-00-DR-L-000201

PLEASE REFER TO BF0144-FBK-BS-00-DR-L-000202

- Notes
1. This drawing is the property of fabrik ltd. It must not be copied or reproduced without written consent.
 2. Only figured dimensions are to be taken from this drawing. All contractors must visit site and be responsible for taking and checking all dimensions related to the works shown on the drawing.

No.	Date	Reason	DY Name
Revisions			



First Floor
 4-8 Emerson Street
 London
 SE1 9DU
 T: 0207 620 1453
 F: 0207 261 9126
 E: london@fabrikuk.com
 W: www.fabrikuk.com

Project
GASCOIGNE WEST PHASE 02 for WATES on behalf of BeFirst DRAFT

Drawing
LANDSCAPE GENERAL ARRANGEMENT PLAN

Scale	Date	Approved	Checked	Drawn
1 : 350	@A1	22/01/2021	MB	MB

Project No.	Drawing No.	Revision
D2977	BF0144-FBK-BS-00-DR-L-000101	P1

- Preliminary
- Issued for Design/Information
- Issued for Planning Approval
- Issued for Tender
- Issued for Construction
- As Built